


|   |  |   |      |
|---|--|---|------|
| TOLERANCES: UNLESS OTHERWISE SPECIFIED  |  | <b>STRIKO DYNARAD</b>   |      |
| XX = ±  | XXX = ±                                | 570 E. 16th Street, Suite 170, Holland, MI 49423<br>Telephone: (616)-355-2327 Fax: (616)-355-2408 |      |
| DIMENSIONS ARE IN INCHES  |  |   |      |
| NOTICE  |  |   |      |
| This document is transmitted solely for the purpose of adding the transaction of business between STRIKO DYNARAD and the recipient and must be returned on request. All drawings, information and data including all design and concrete contained herein are the property of STRIKO DYNARAD and may not be reproduced or copied in whole or in part without the written consent of STRIKO DYNARAD. It is to be used for the manufacture of any equipment described without the specific written consent of STRIKO DYNARAD. |  |   |      |
| DRAFTSMAN   | DATE                                   | DRAWING NO.   | REV. |
| NSA   | 8/24/08                                | 1260  | C    |
| CHECKED BY  | DATE                                   |   |      |
| SE  | 8/24/08                                |   |      |
| USED ON DRAWING NO.   | SCALE                                  |   |      |
|   | NA                                     |   |      |
| REV   | DESCRIPTION                            | BY  | DATE |
| C   | ADD LINE 2-38. EXTRACTOR "WINDOW" LINE | RCO   | 8/29 |
| B   | AS BUILT - PKY                         | NSA   | 8/28 |

|     |  |     |      |
|-----|--|-----|------|
| REV | DESCRIPTION                            | BY  | DATE |
| C   | ADD LINE 2-38. EXTRACTOR "WINDOW" LINE | RCO | 8/29 |
| B   | AS BUILT - PKY                         | NSA | 8/28 |

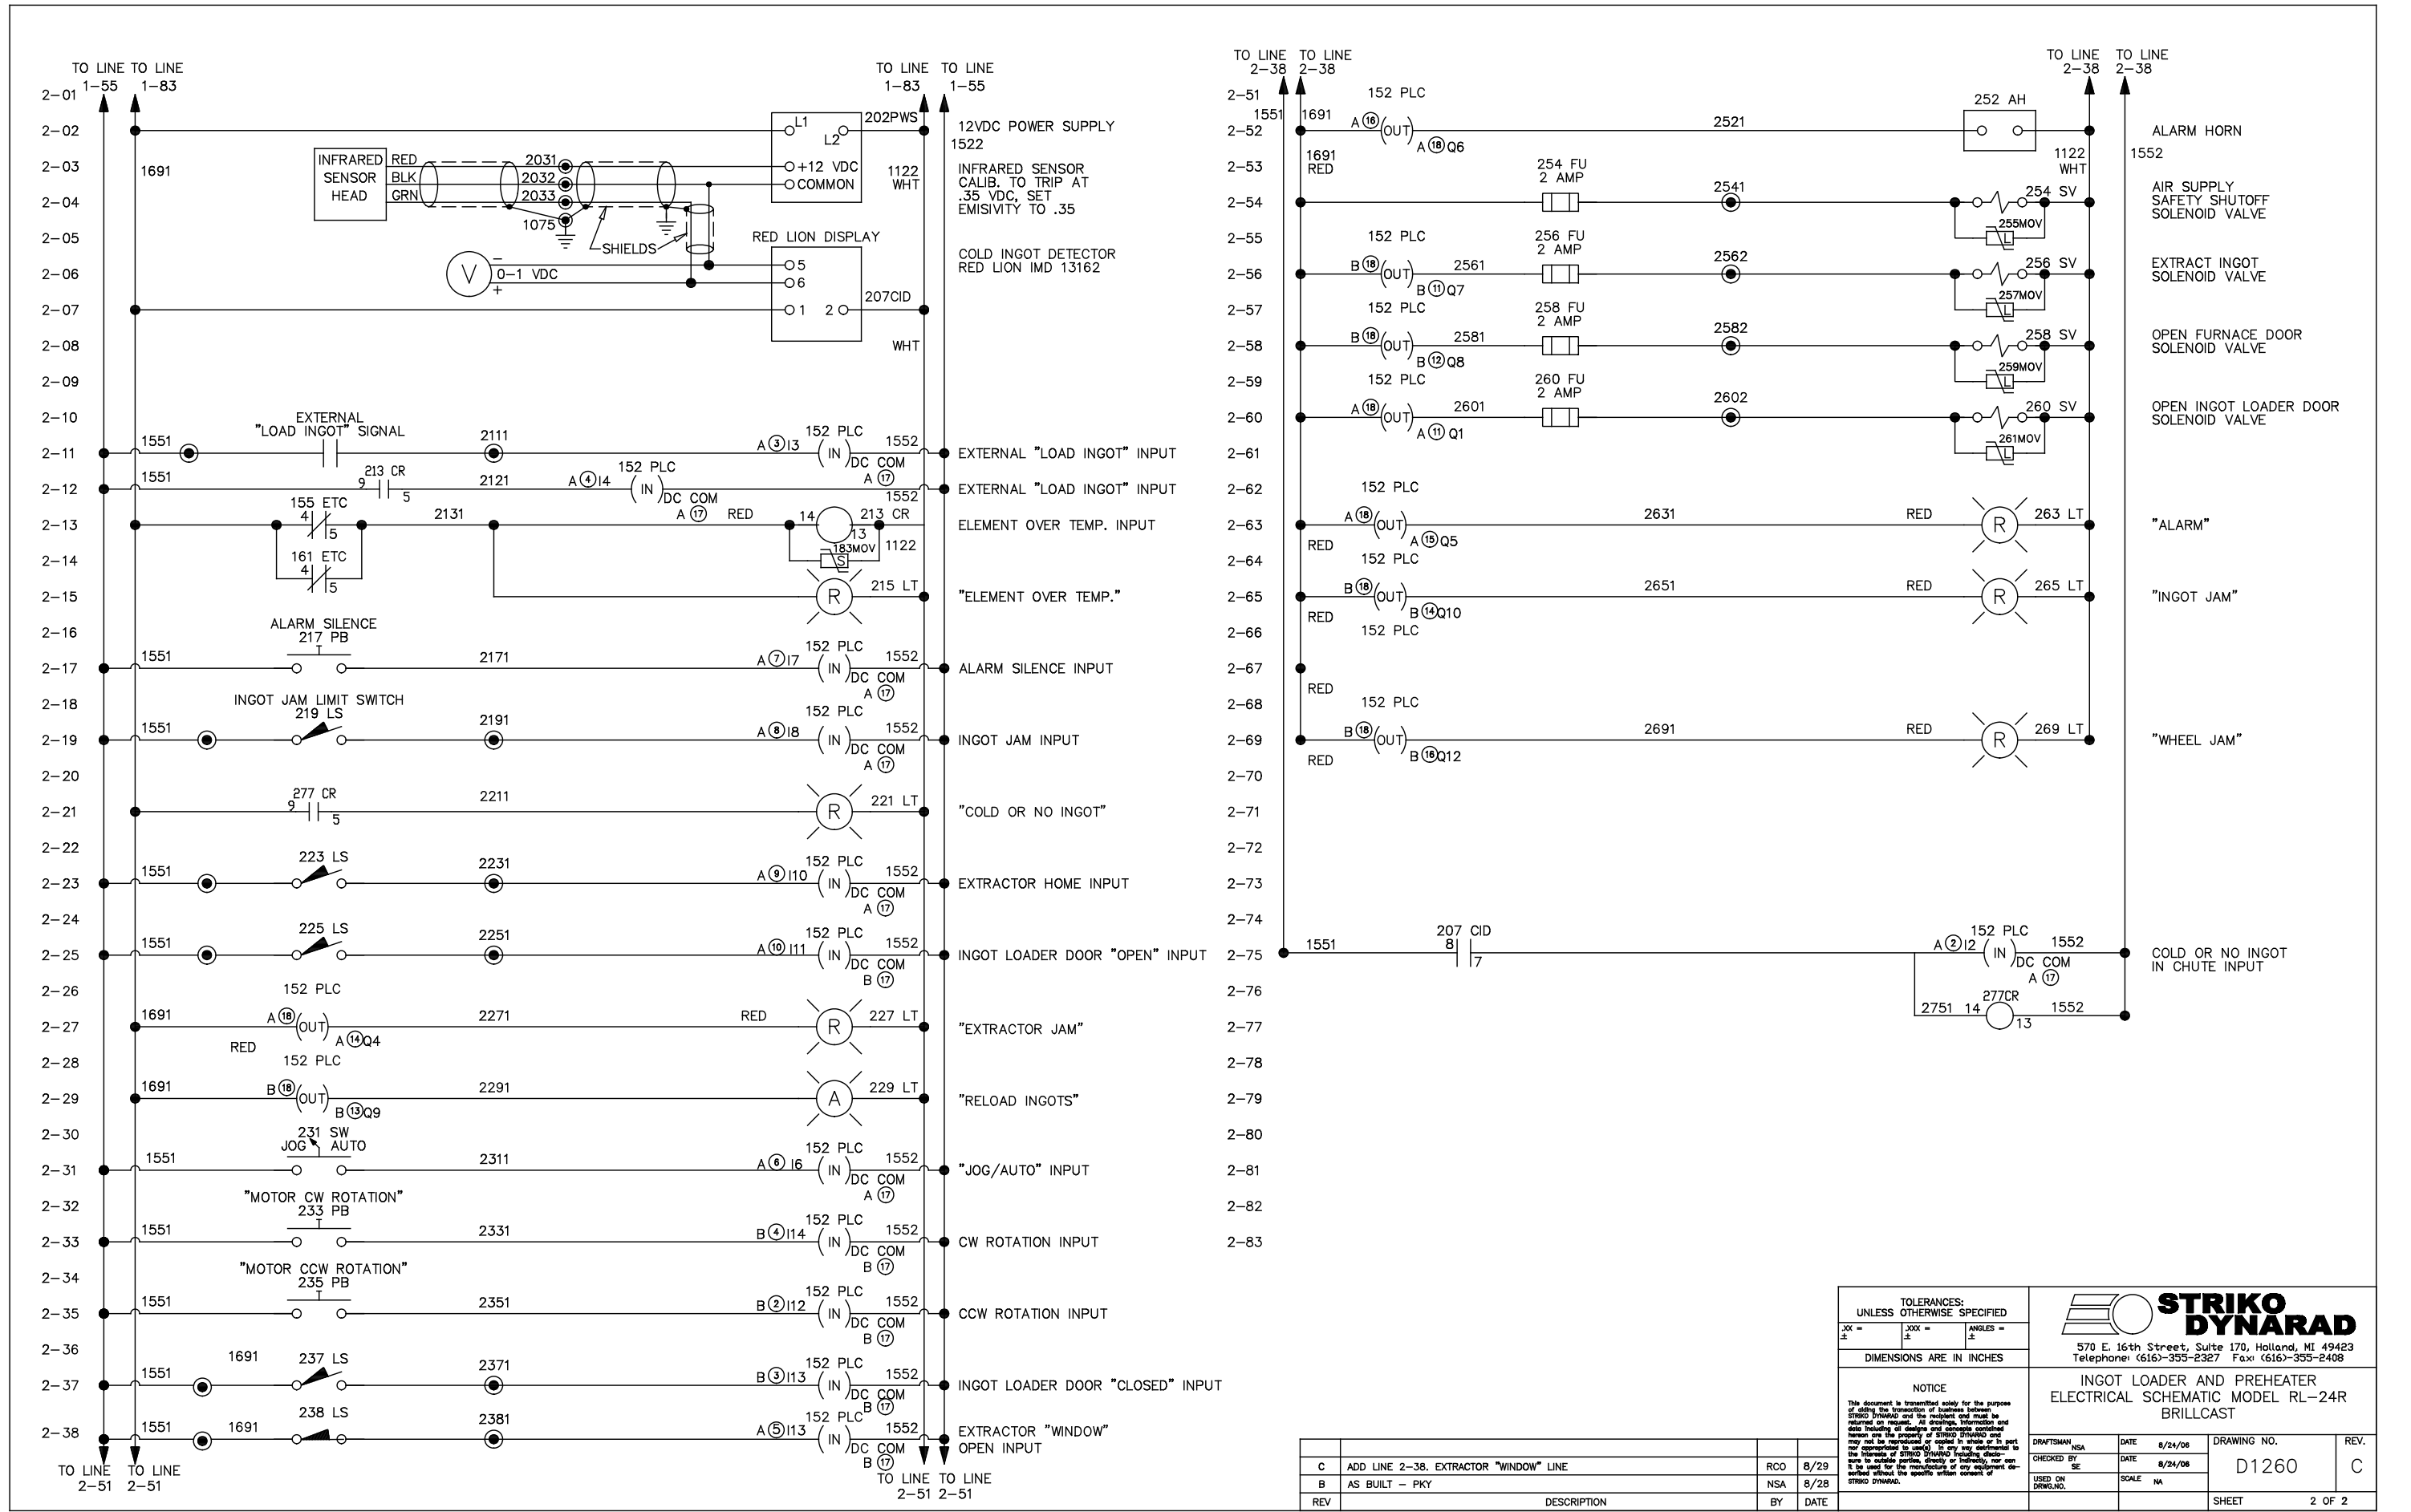

|                             |         |  |      |
|-----------------------------|---------|--|------|
| UNLESS TOLERANCES SPECIFIED |         | <b>STRIKO DYNARAD</b><br>570 E. 16th Street, Suite 170, Holland, MI 49423<br>Telephone: (616)-355-2327 Fax: (616)-355-2408   |      |
| XX = ±                      | XXX = ± | NOTICE<br>This document is transmitted solely for the purpose of adding the transaction of business between STRIKO DYNARAD and the recipient and must be returned on request. All drawings, information and data including all designs and concepts contained herein are the property of STRIKO DYNARAD and may not be reproduced or copied in whole or in part without the written consent of STRIKO DYNARAD. |      |
| DIMENSIONS ARE IN INCHES    |         | INGOT LOADER AND PREHEATER<br>ELECTRICAL SCHEMATIC MODEL RL-24R<br>BRILLCAST   |      |
| DRAFTSMAN                   | DATE    | DRAWING NO.  | REV. |
| NSA                         | 8/24/08 | D1260  | C    |
| CHECKED BY                  | DATE    |  |      |
| SE                          | 8/24/08 |  |      |
| USED ON DRAWING NO.         | SCALE   |  |      |
|                             | NA      |  |      |
| SHEET                       |         | 2 OF 2   |      |

| REV | DESCRIPTION                            | BY  | DATE |
|-----|--|-----|------|
| C   | ADD LINE 2-38, EXTRACTOR "WINDOW" LINE | RCO | 8/29 |
| B   | AS BUILT - PKY                         | NSA | 8/28 |